


**BUILDING PERMIT APPLICATION PLAN
LAND OF JANE BEAL-COSTELLO
307 PORTSMOUTH AVENUE
SEABROOK, NH**

SCALE: 1"=20' APRIL 18, 2010




STOCKTON SERVICES
PO BOX 1306, HAMPTON, NH 03843-1306
603 929-7404

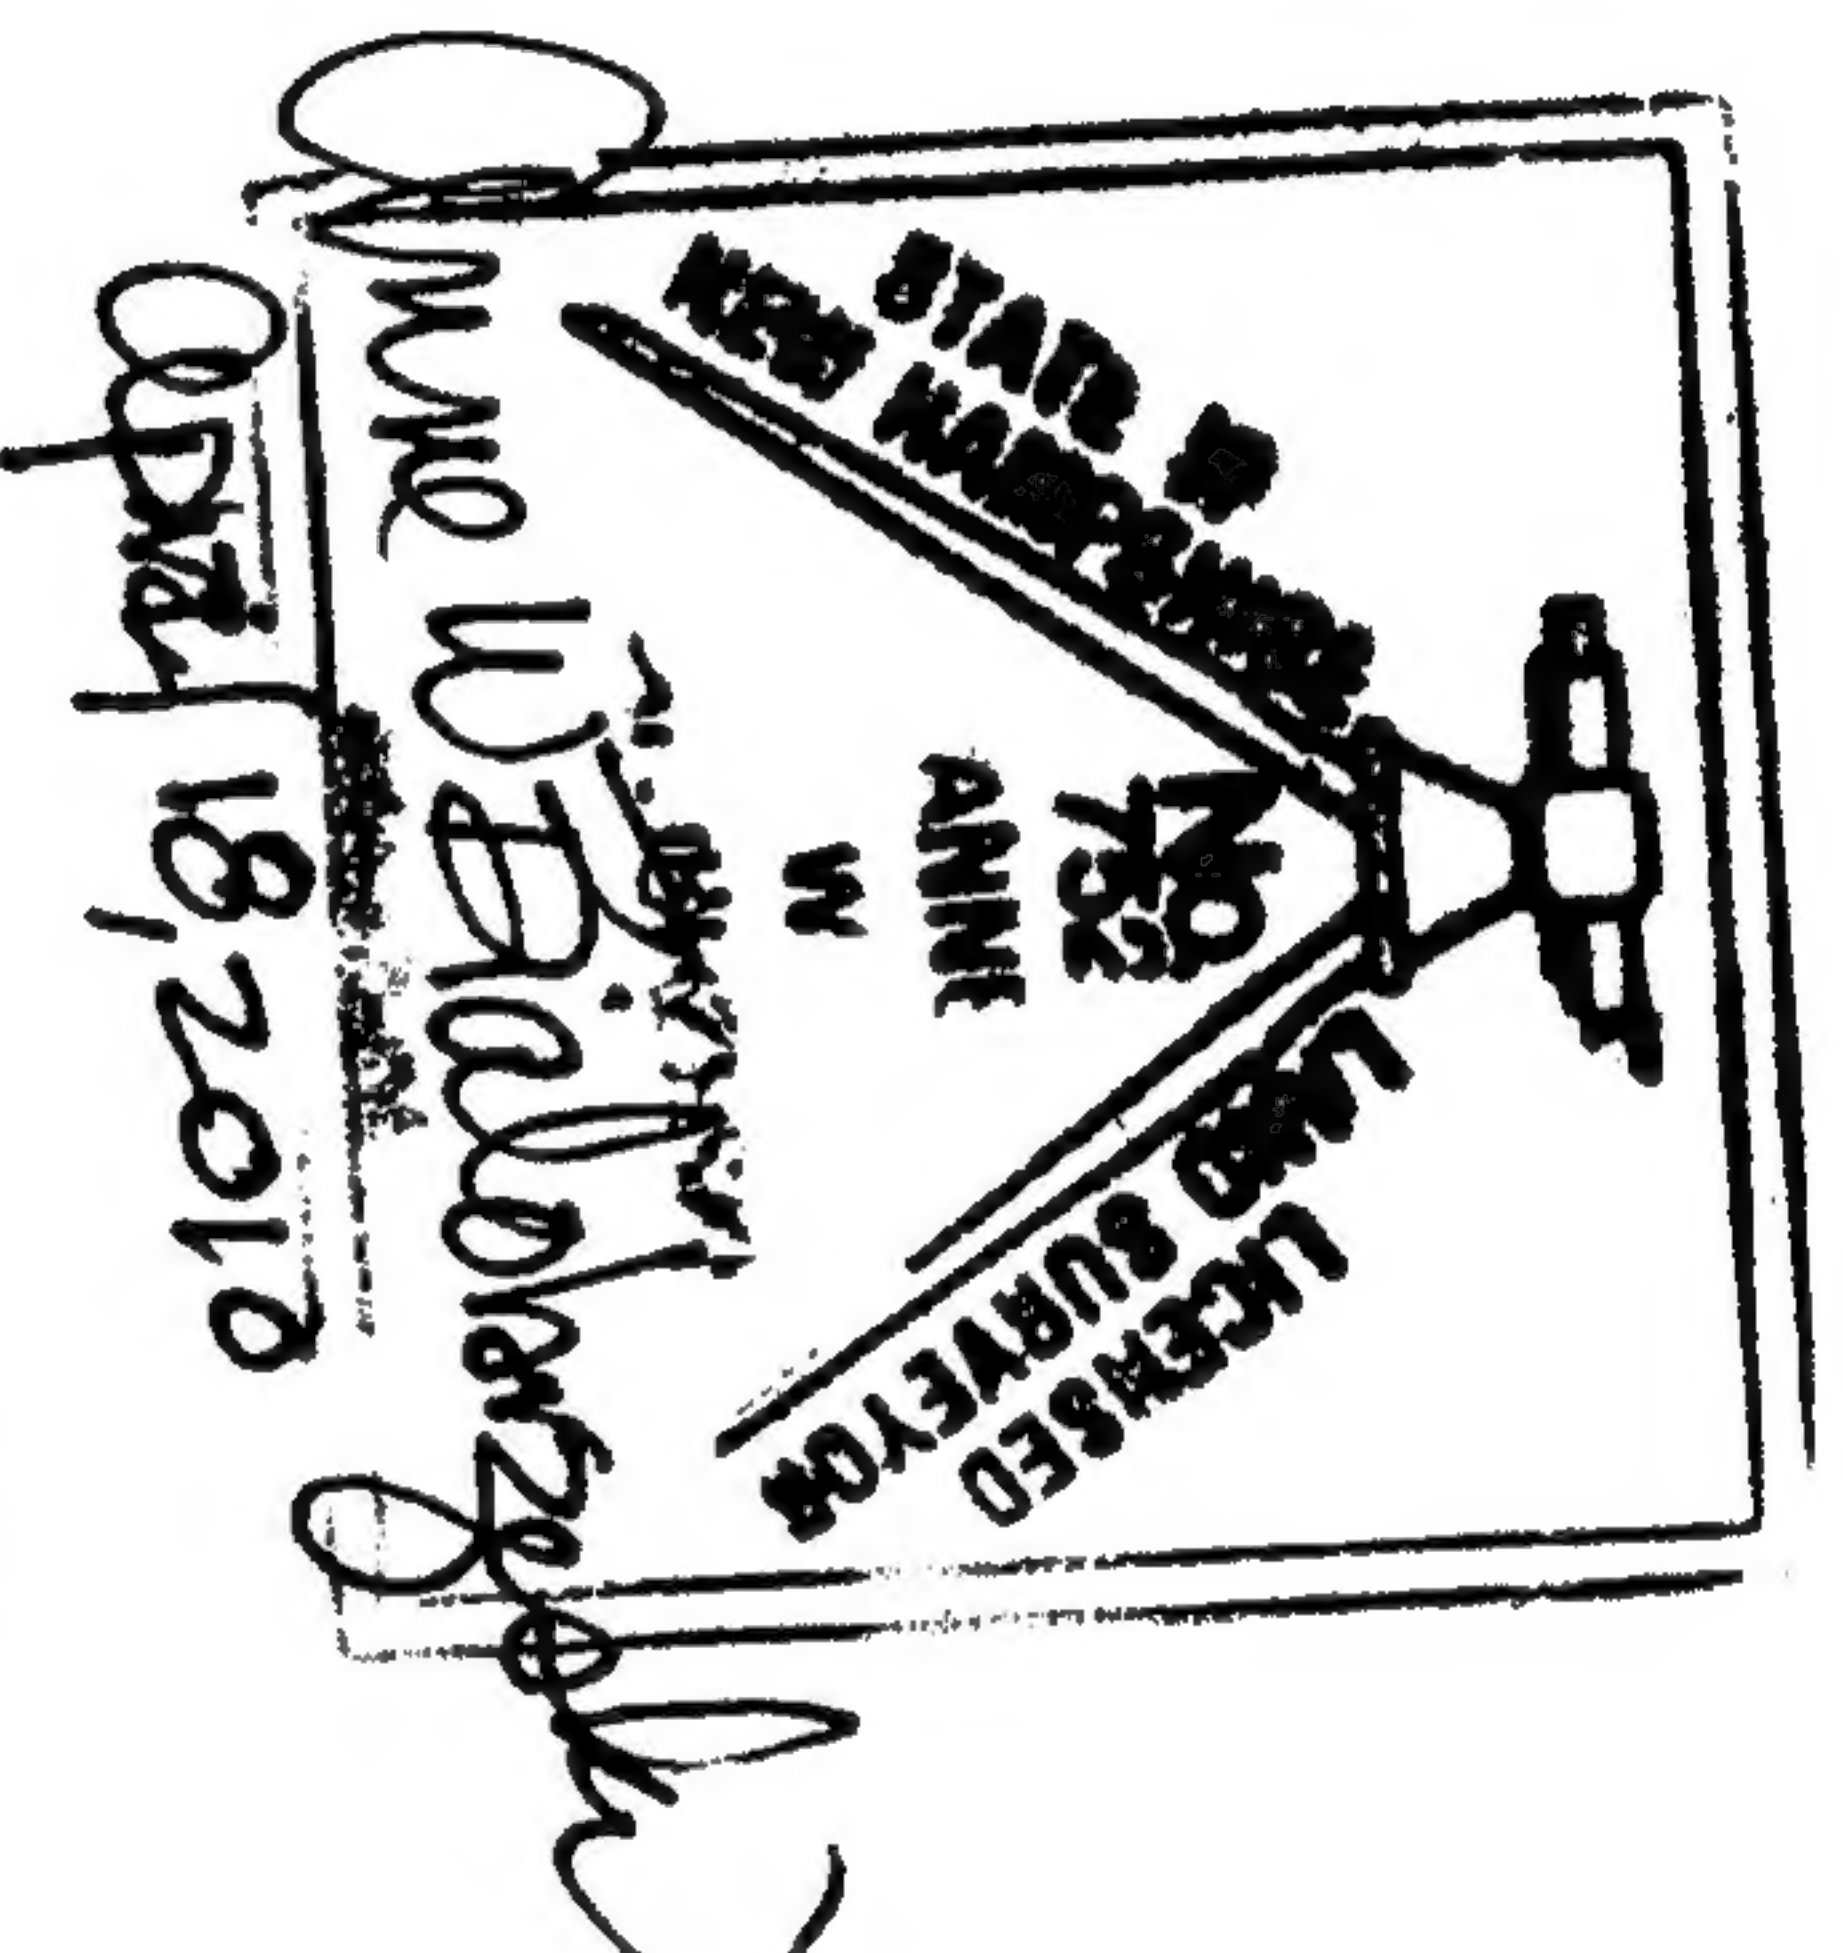

THE PURPOSE OF THIS PLAN IS TO SHOW
PROPOSED BUILDING AND SETBACKS FOR
BUILDING PERMIT APPLICATION ONLY.
NO OTHER REPRESENTATION IS INTENDED
OR IMPLIED.

NOTE:
BUILDING SETBACKS SHOWN
ARE TO ROOF OVERHANG.

OWNER OF RECORD:
JANE BEAL-COSTELLO
28 FARWOOD RD
WINDHAM, NH 03087
TAX MAP 20 LOT 307
RCRD 4226-1011
ZONING CLASS: 2R
BEACH RESIDENTIAL

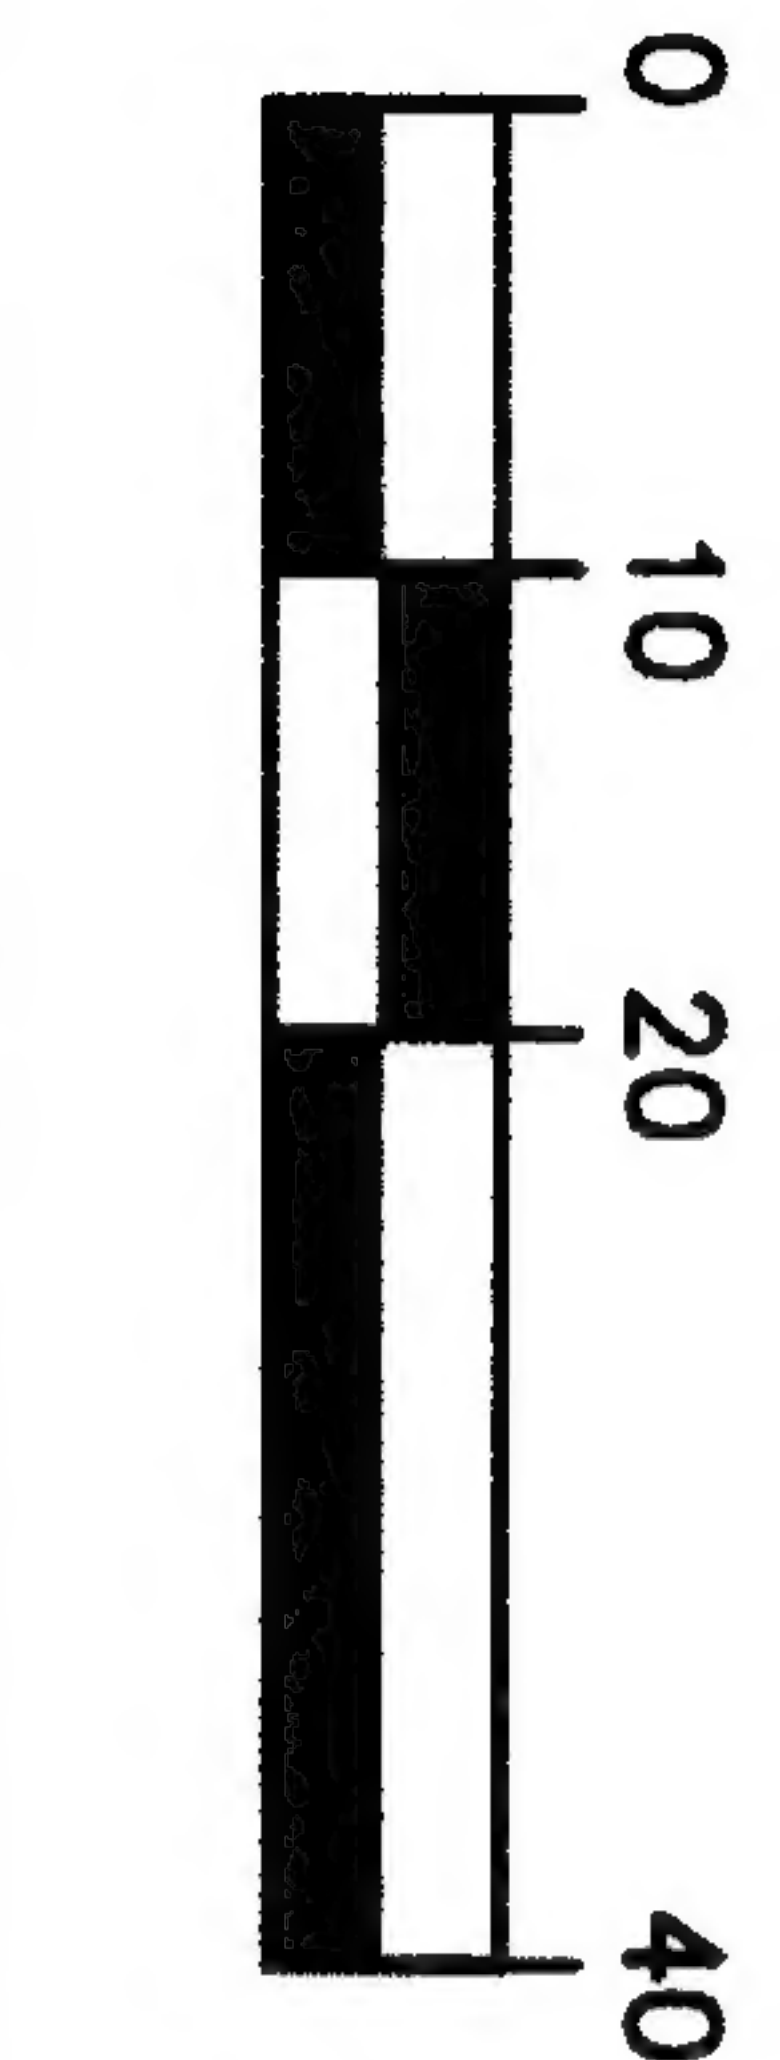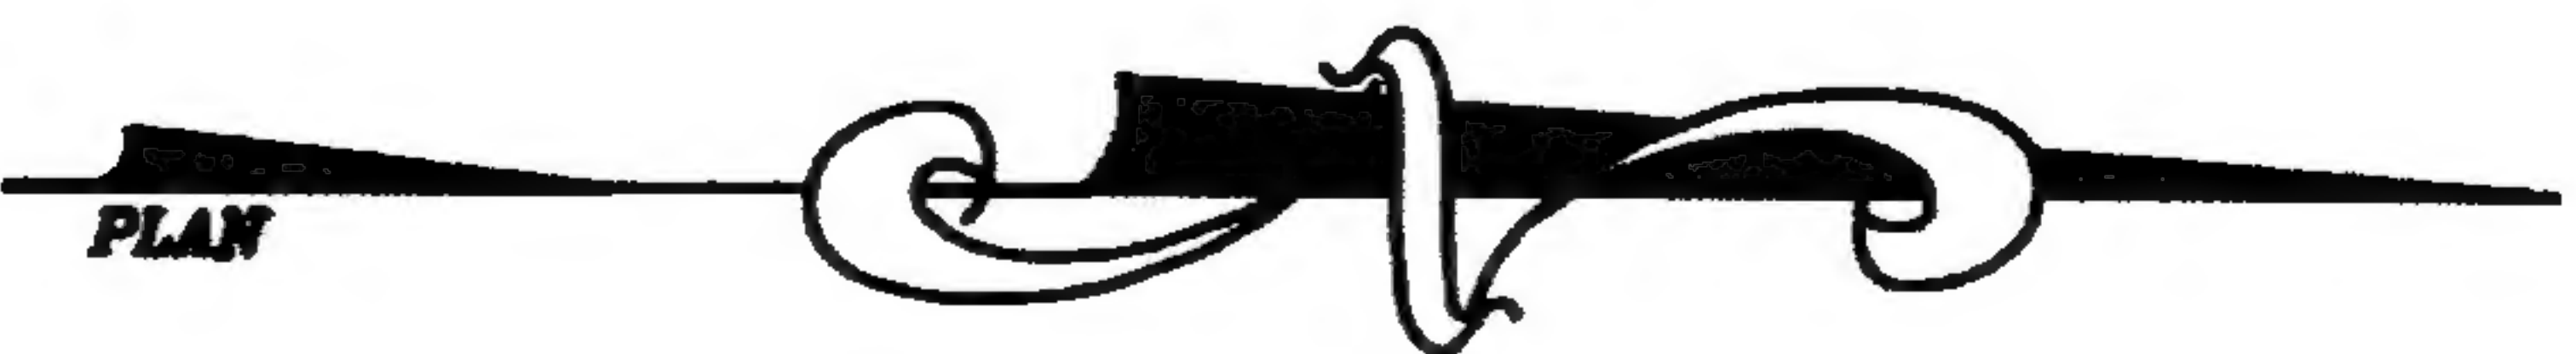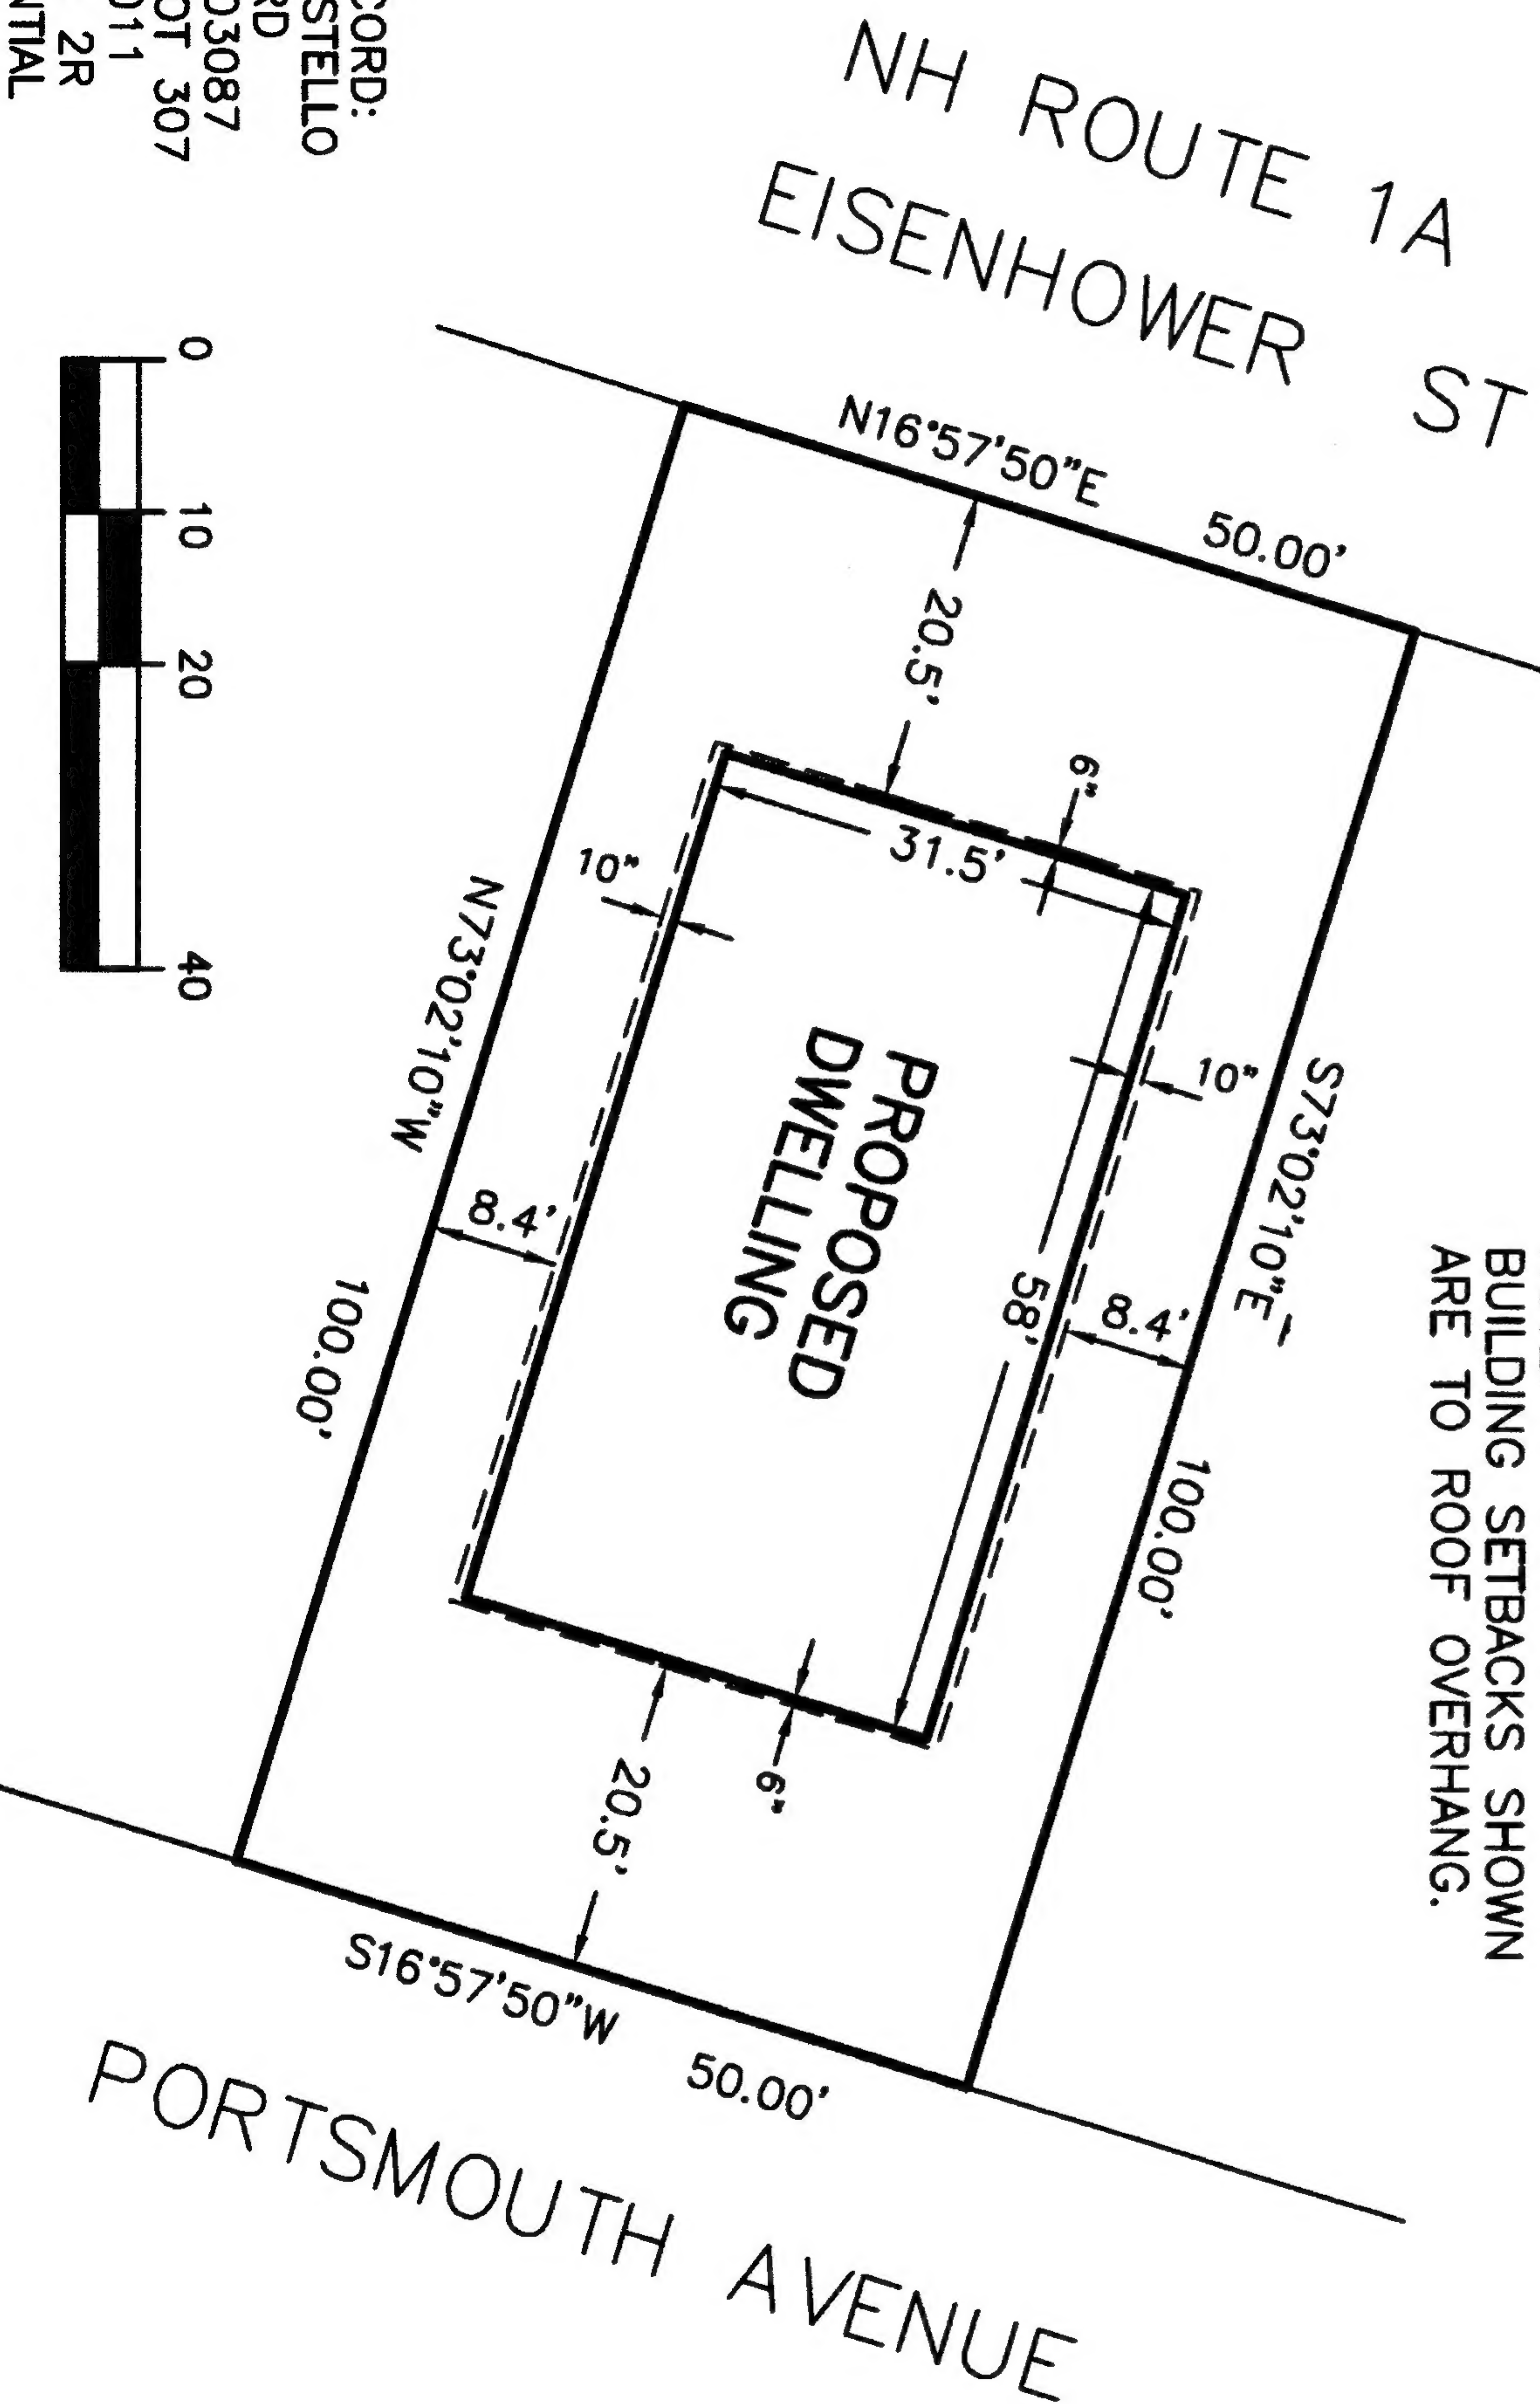


**BUILDING PERMIT APPLICATION PLAN
LAND OF JANE BEAL-COSTELLO
307 PORTSMOUTH AVENUE
SEABROOK, NH**

SCALE: 1"=20' APRIL 20, 2010




STOCKTON SERVICES
PO BOX 1306, HAMPTON, NH 03843-1306
603 929-7404

OWNER OF RECORD:
JANE BEAL-COSTELLO
28 FARWOOD RD
WINDHAM, NH 03087
TAX MAP 20 LOT 307
RCRD 4226-1011
ZONING CLASS: 2R
BEACH RESIDENTIAL

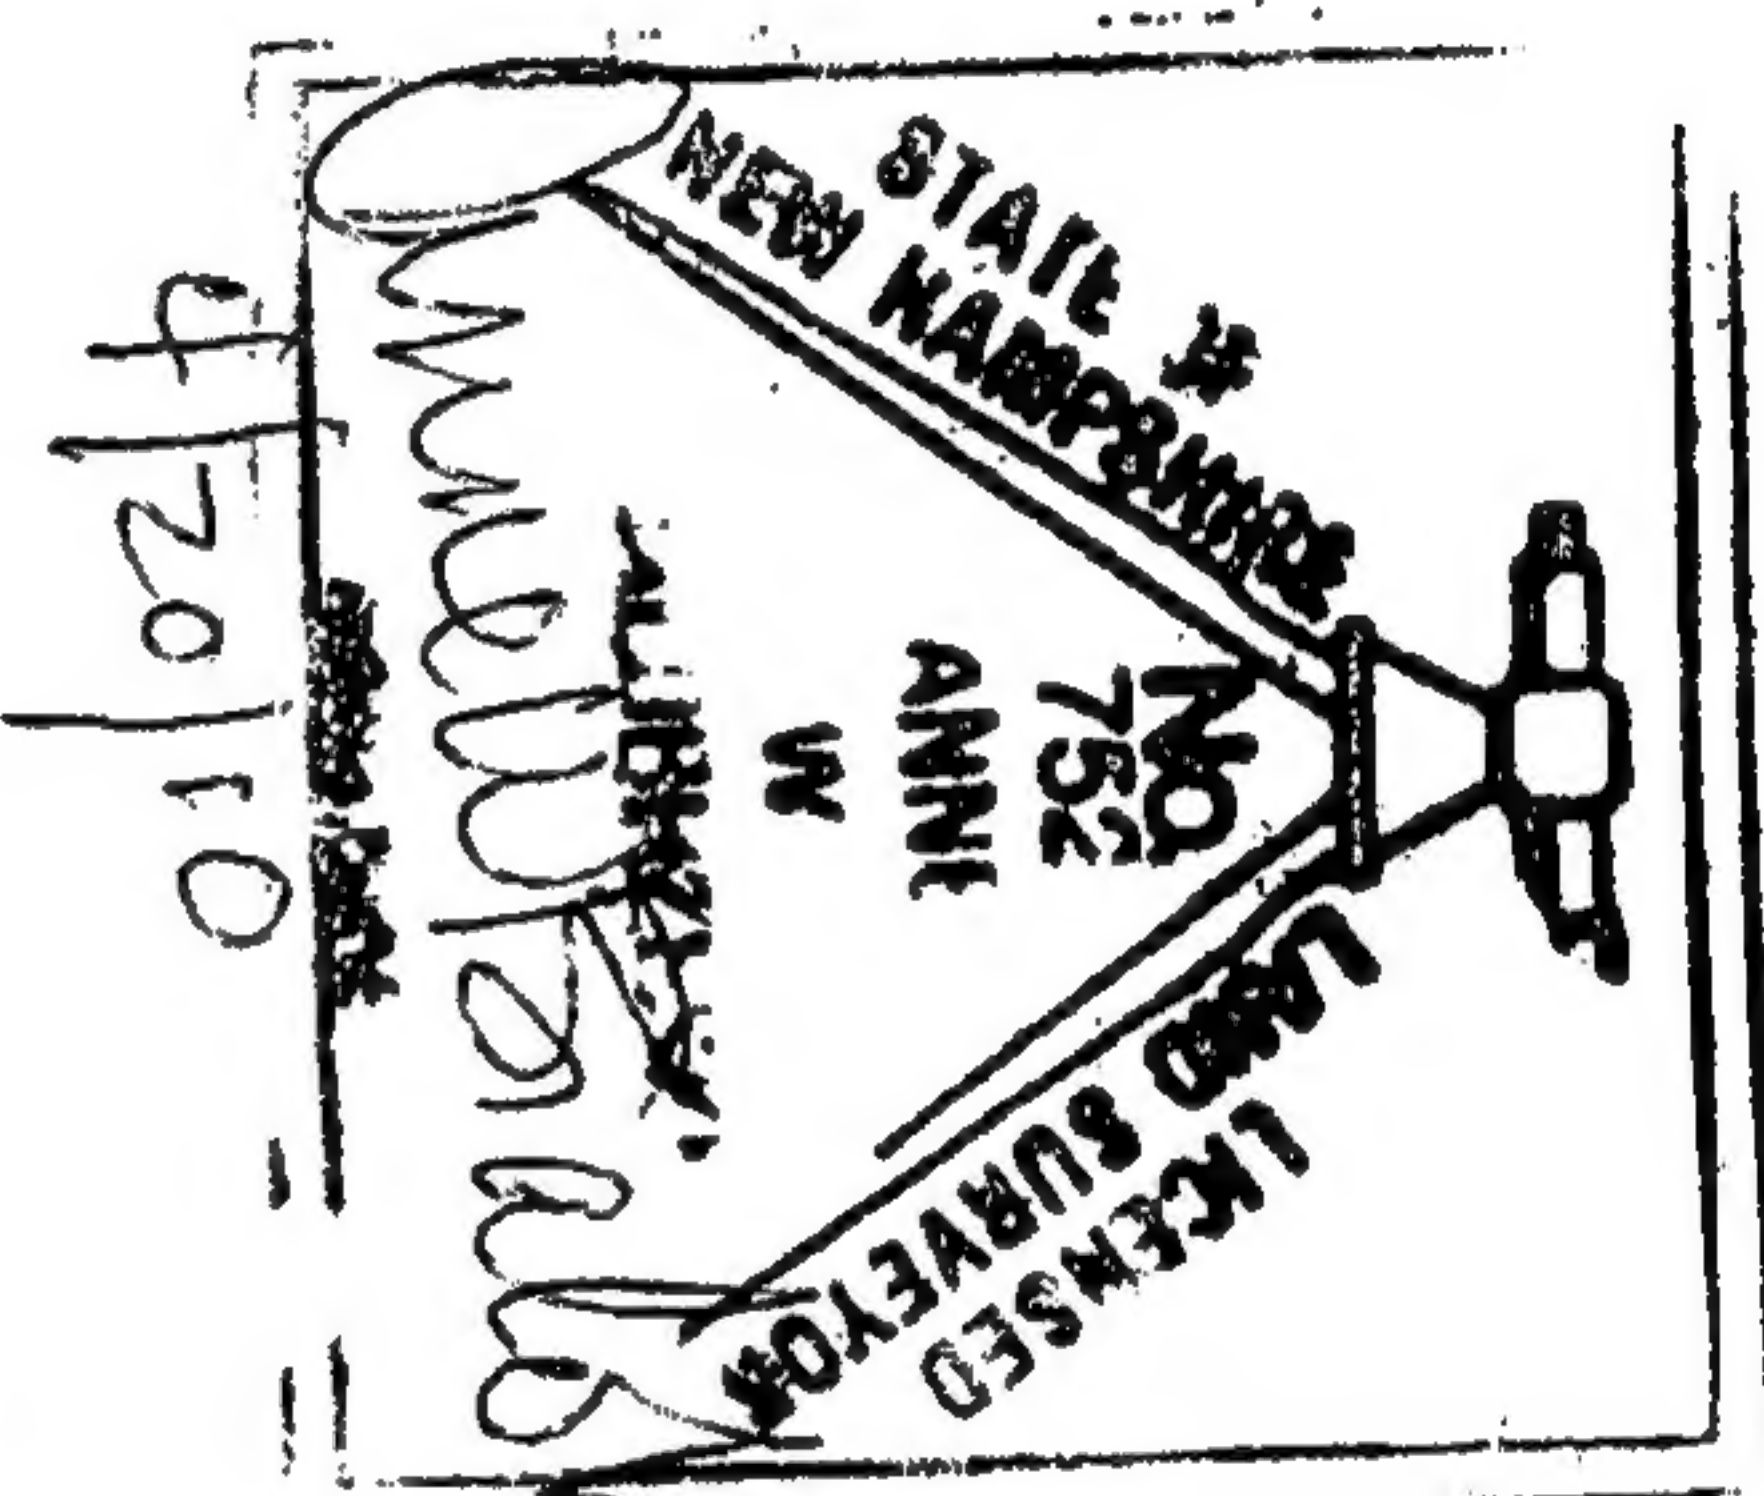

THE PURPOSE OF THIS PLAN IS TO SHOW
PROPOSED BUILDING AND SETBACKS FOR
BUILDING PERMIT APPLICATION ONLY.
NO OTHER REPRESENTATION IS INTENDED
OR IMPLIED.

NOTE:
BUILDING SETBACKS SHOWN
ARE TO ROOF OVERHANG.

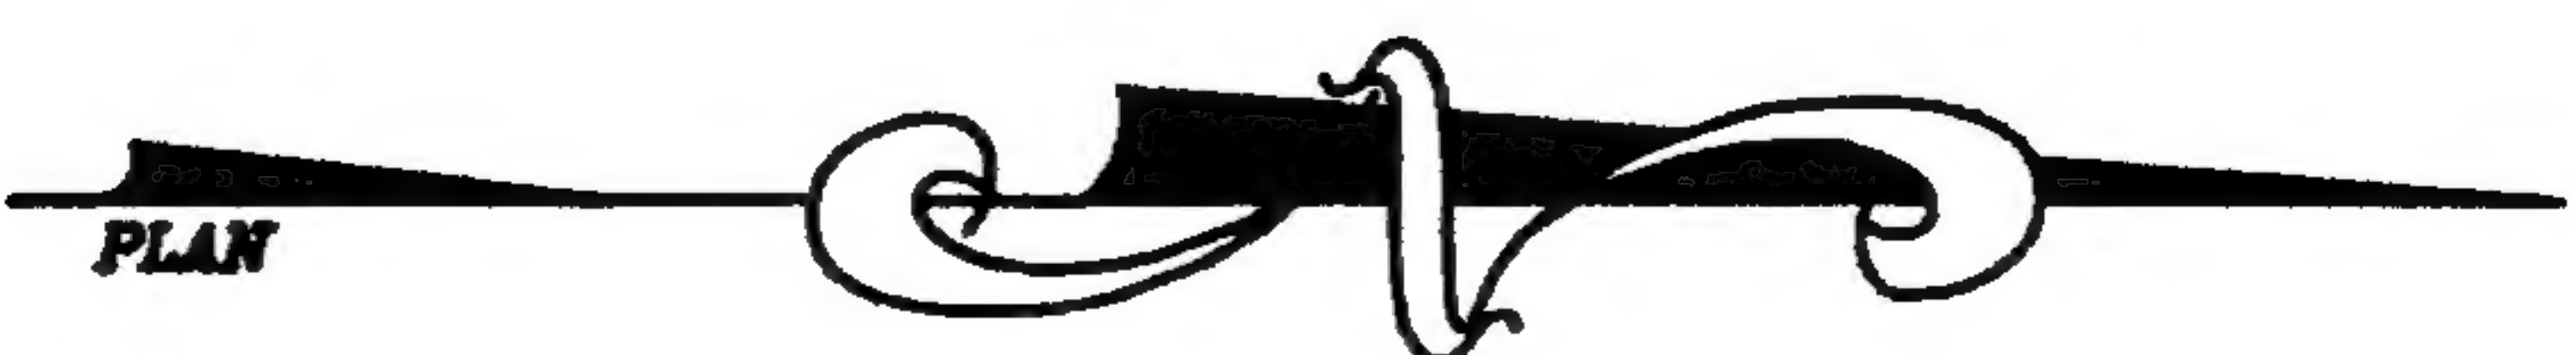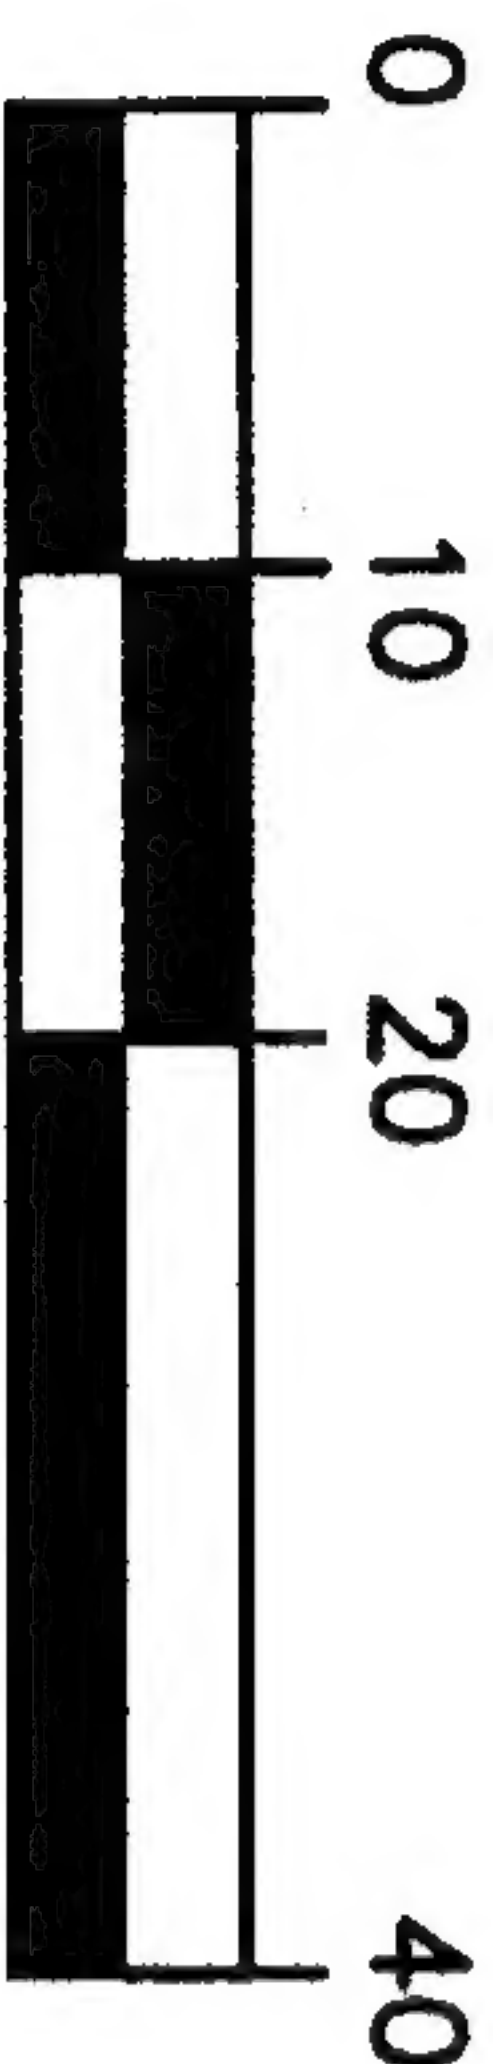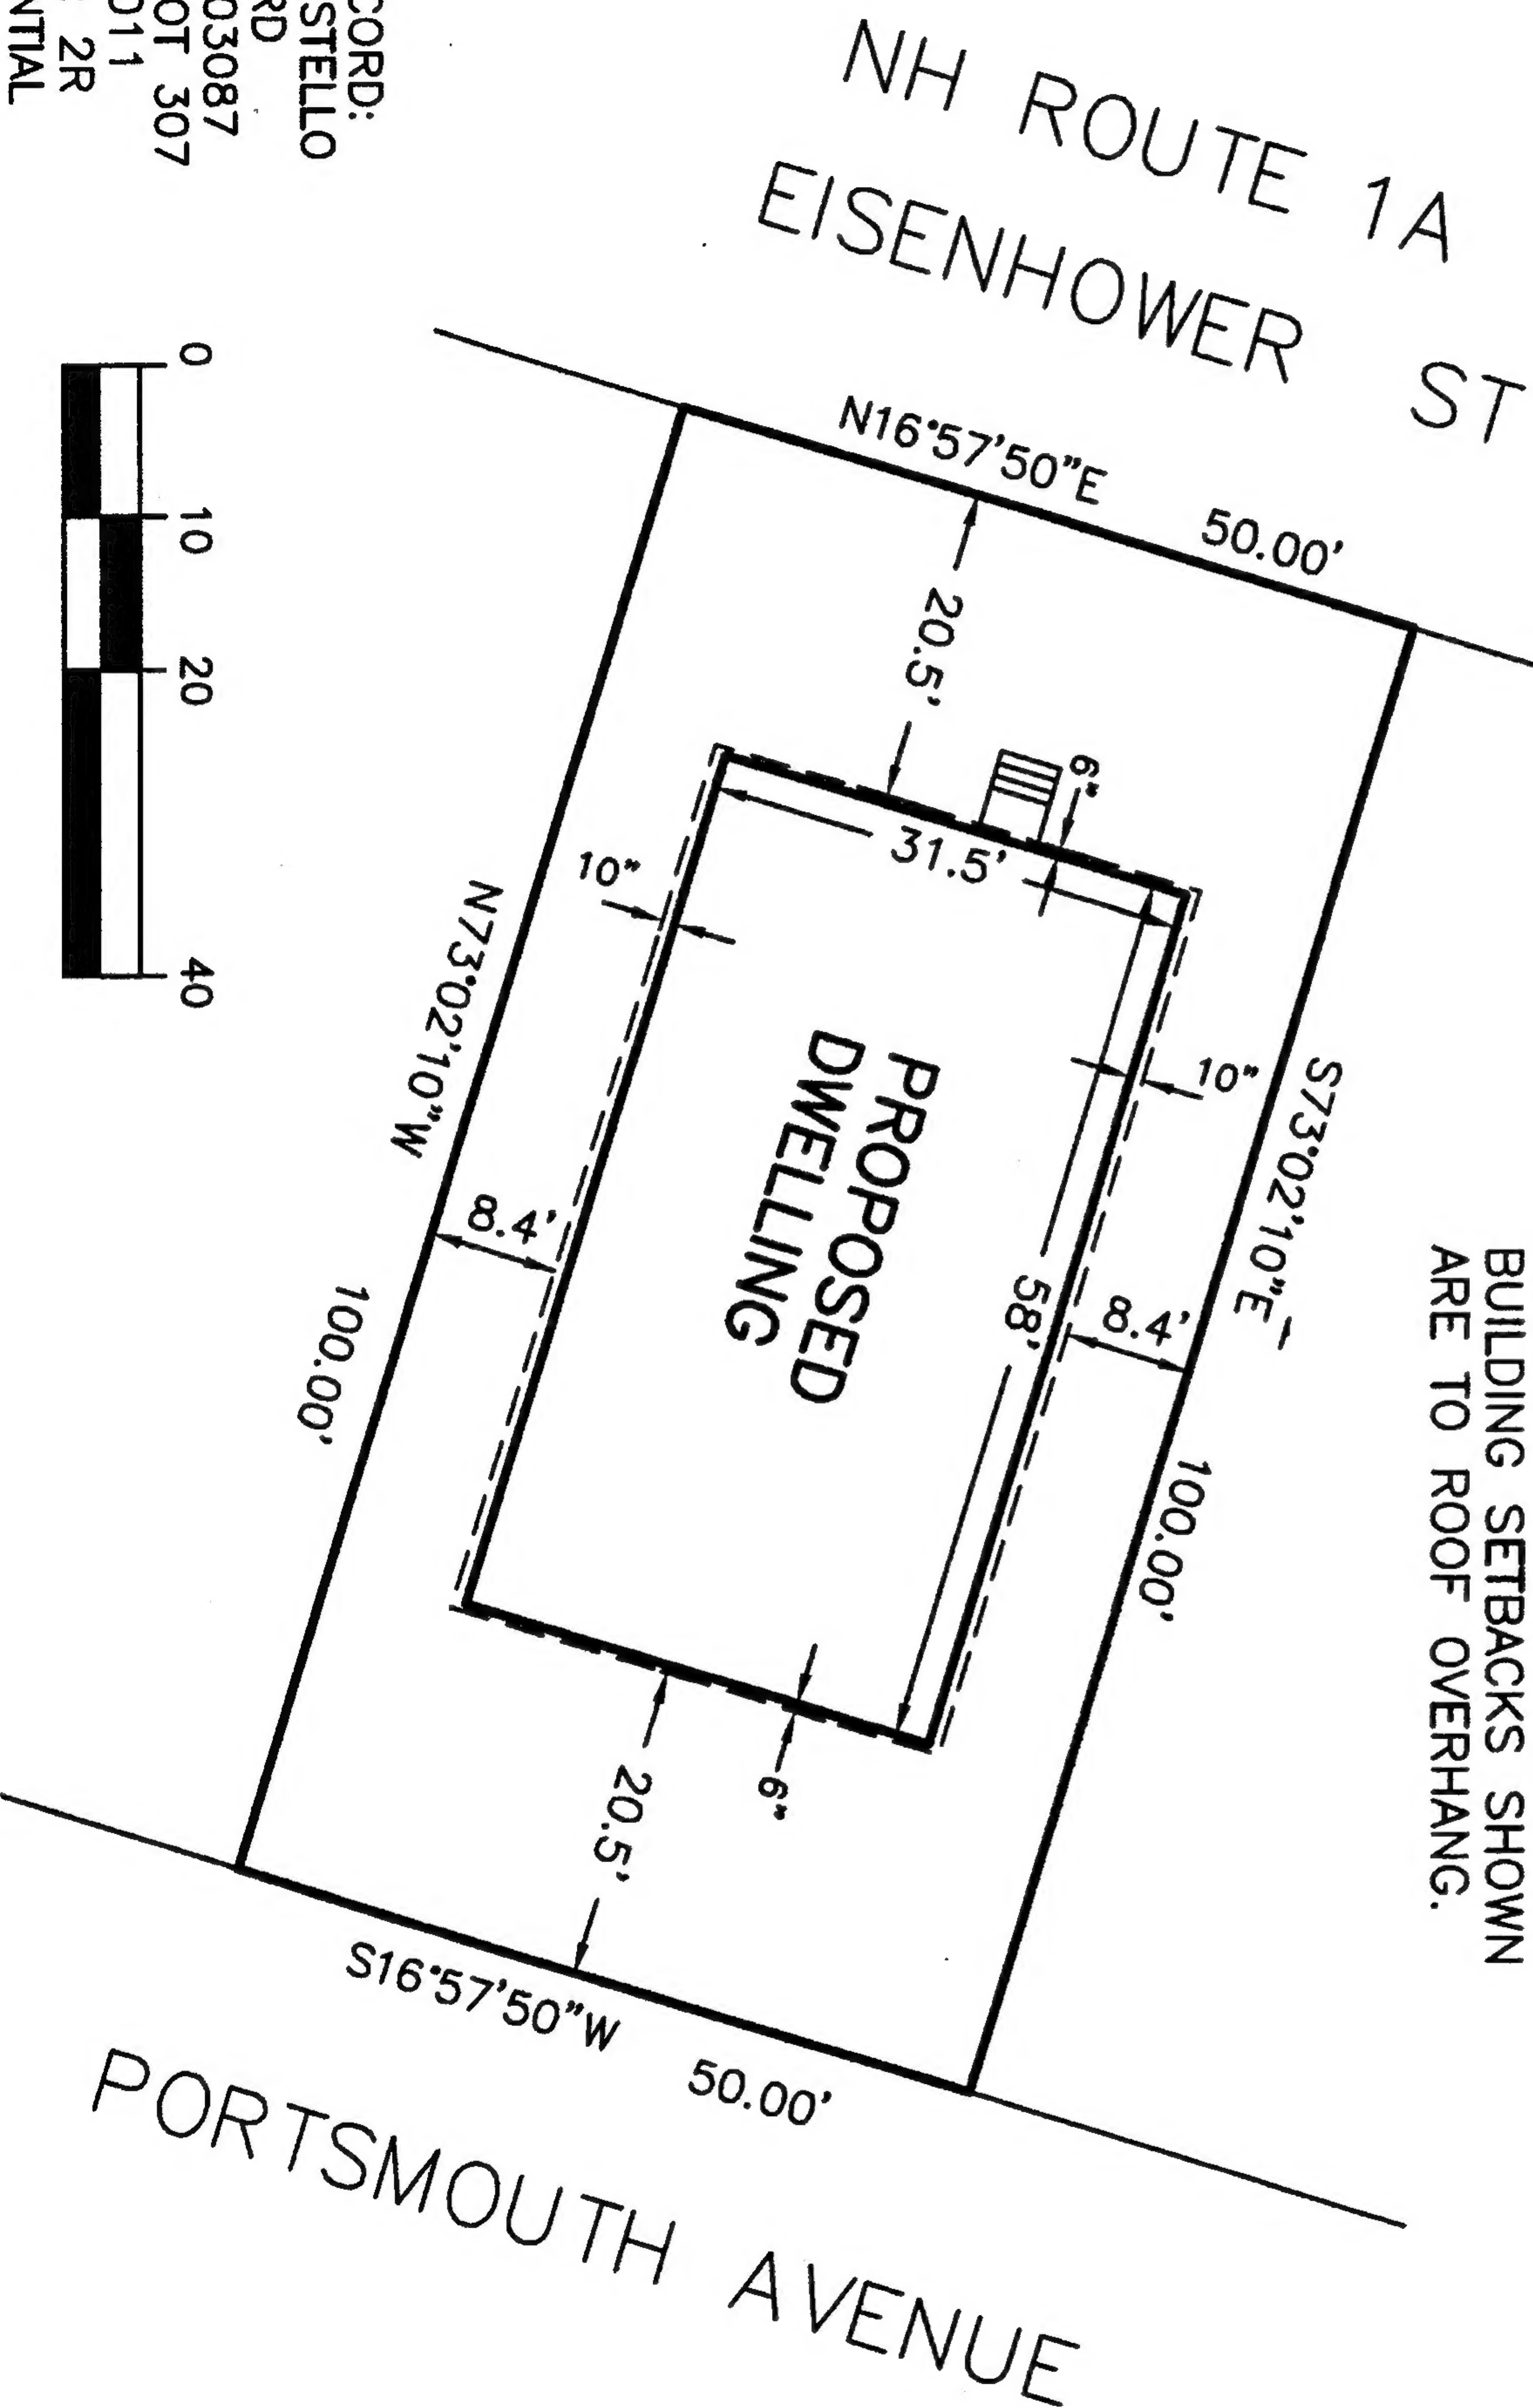


FOUNDATION CERTIFICATION PLAN
LAND OF JANE BEAL-COSTELLO
307 PORTSMOUTH AVENUE
SEABROOK, NH

SCALE: 1"=20' MAY 27, 2010

STOCKTON SERVICES
PO BOX 1306, HAMPTON, NH 03843-1306
603 929-7404

THE PURPOSE OF THIS PLAN IS TO CERTIFY TO
THE LOCATION OF FOUNDATION AS CONSTRUCTED.
NO OTHER REPRESENTATION IS INTENDED OR IMPLIED.

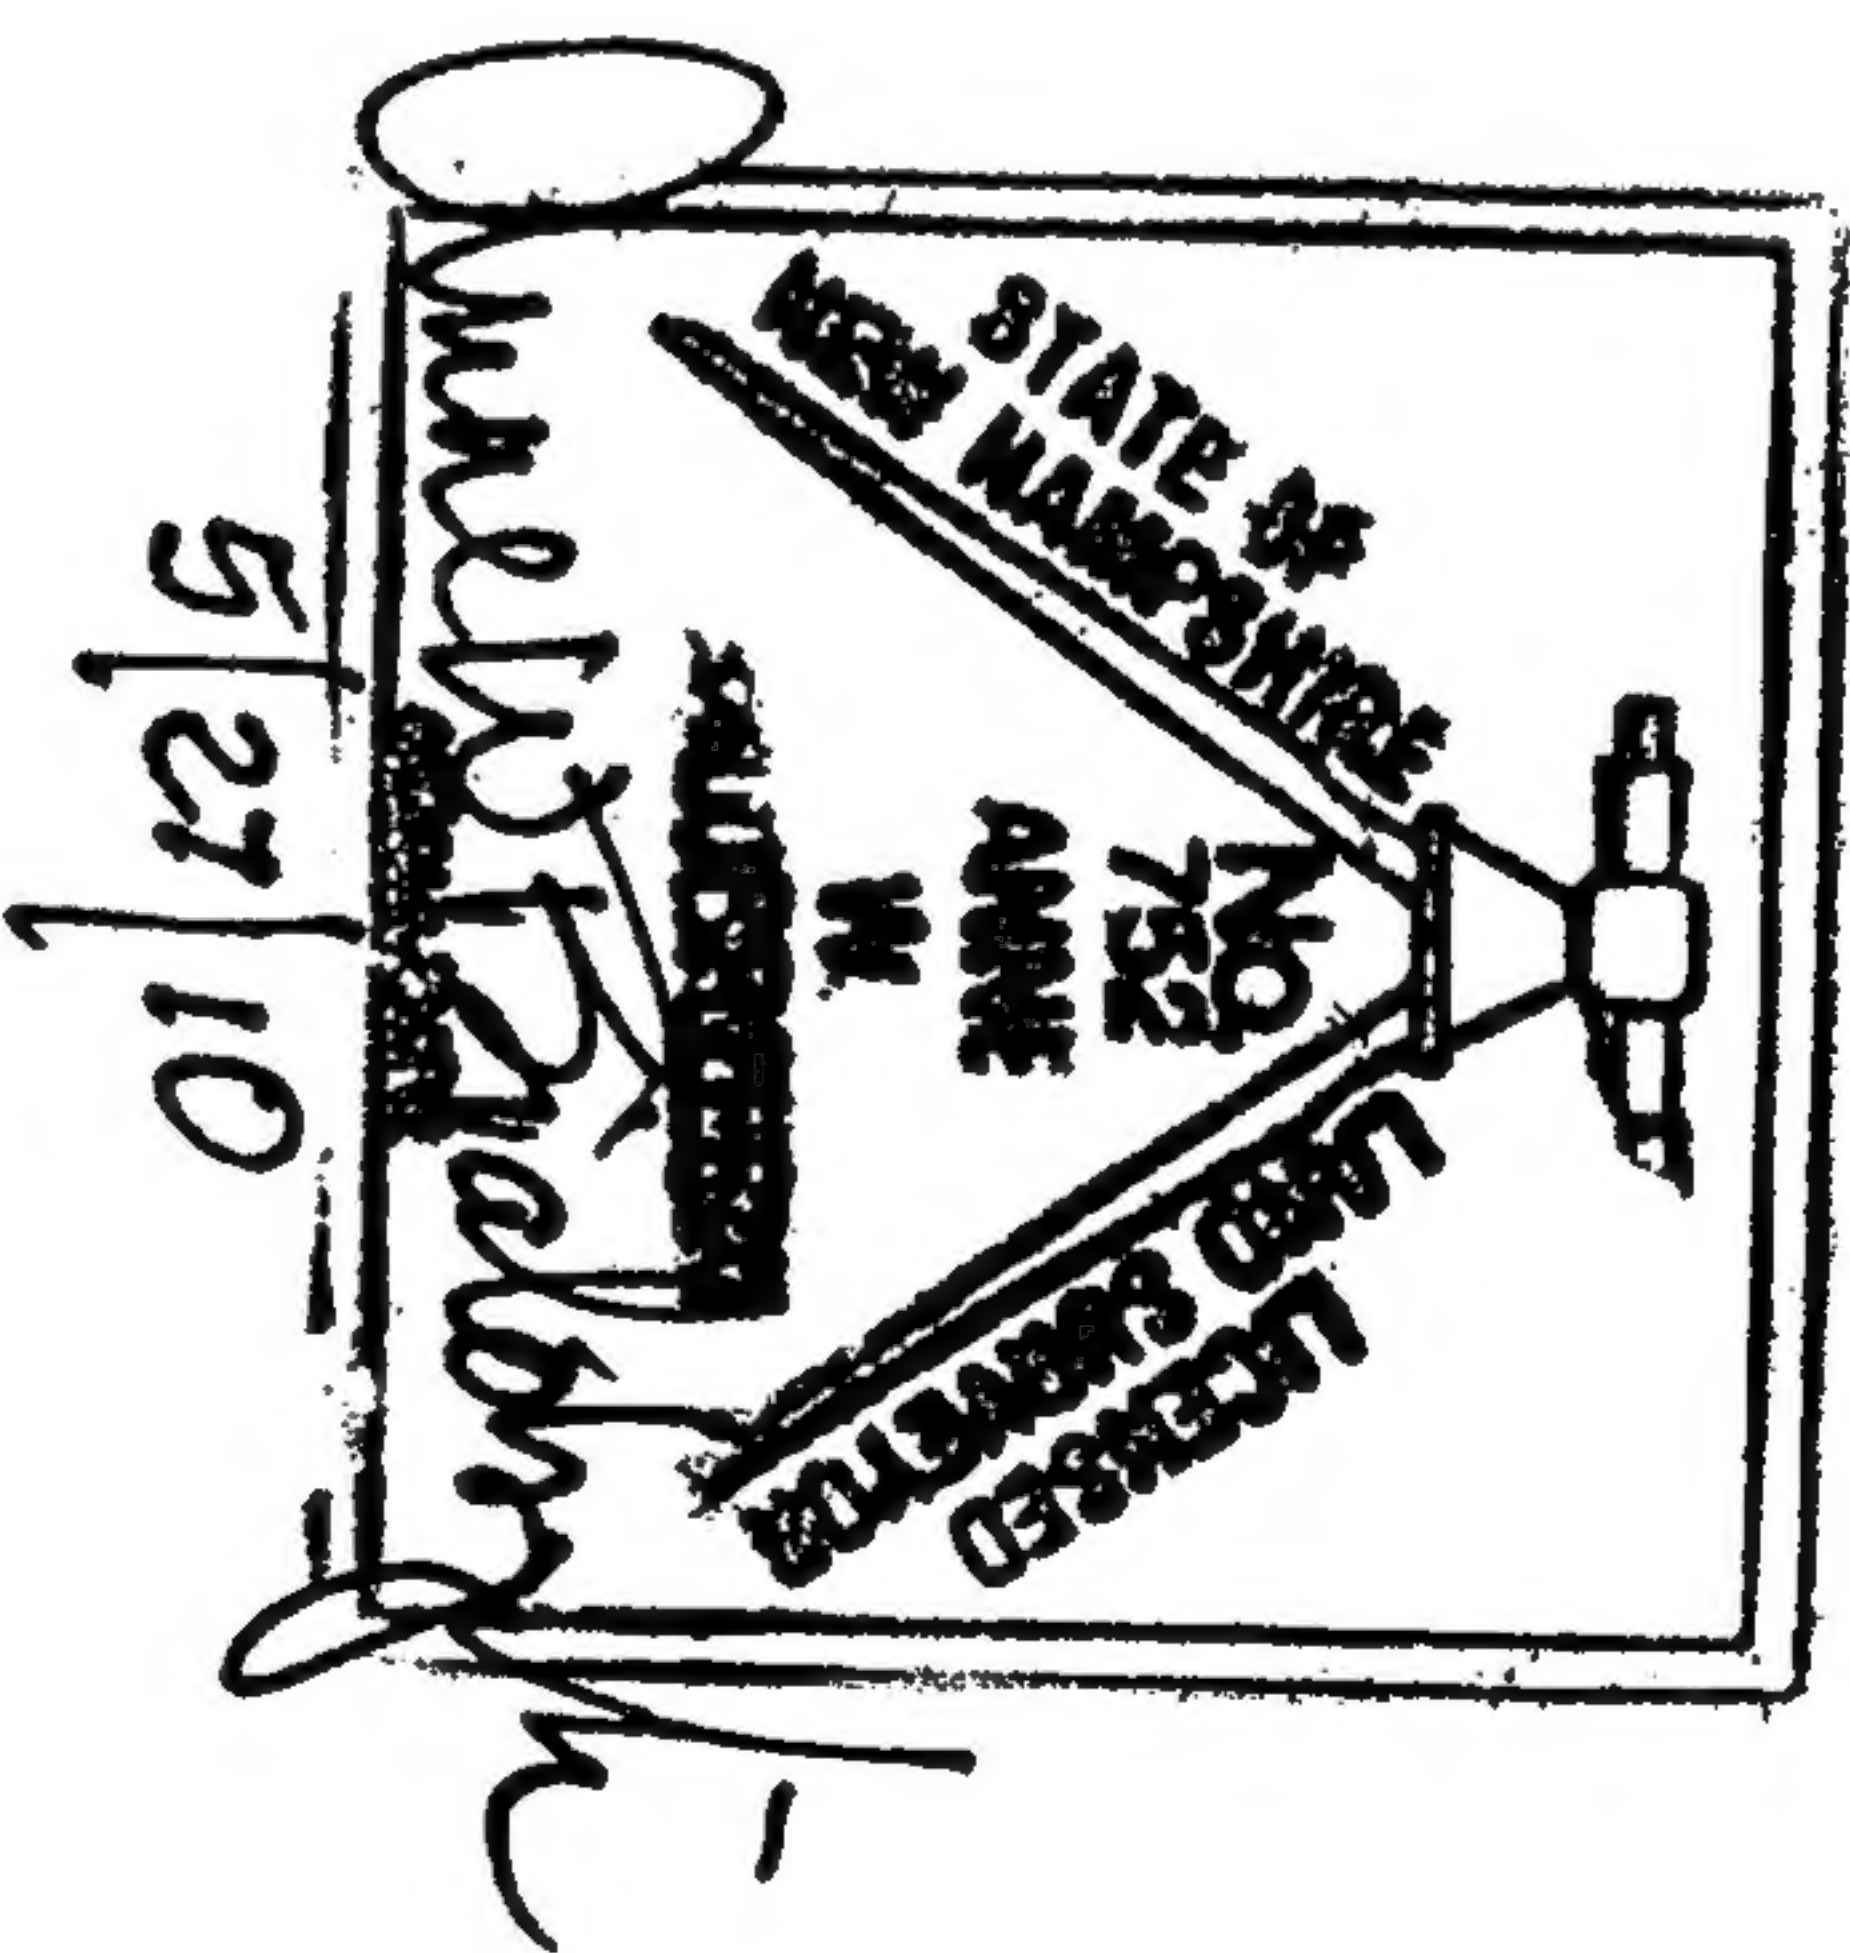

NH ROUTE 1A
EISENHOWER ST



OWNER OF RECORD:
JANE BEAL-COSTELLO
28 FARWOOD RD
WINDHAM, NH 03087
TAX MAP 20 LOT 307
RCRD 4226-1011
ZONING CLASS: 2R
BEACH RESIDENTIAL

